



Path: \\BACATLFP01\PROJECTS\DEKALB\151033_DEKALB_SEWER_D8_PHASE1_CAD2-SHEETS\AS-BUILT\PROJECT 19 FILENAME: 151033-P19-C1010106.DWG PLOT DATE: 7/13/2020 2:58 PM CAD USER: PHILLIP DAVIS

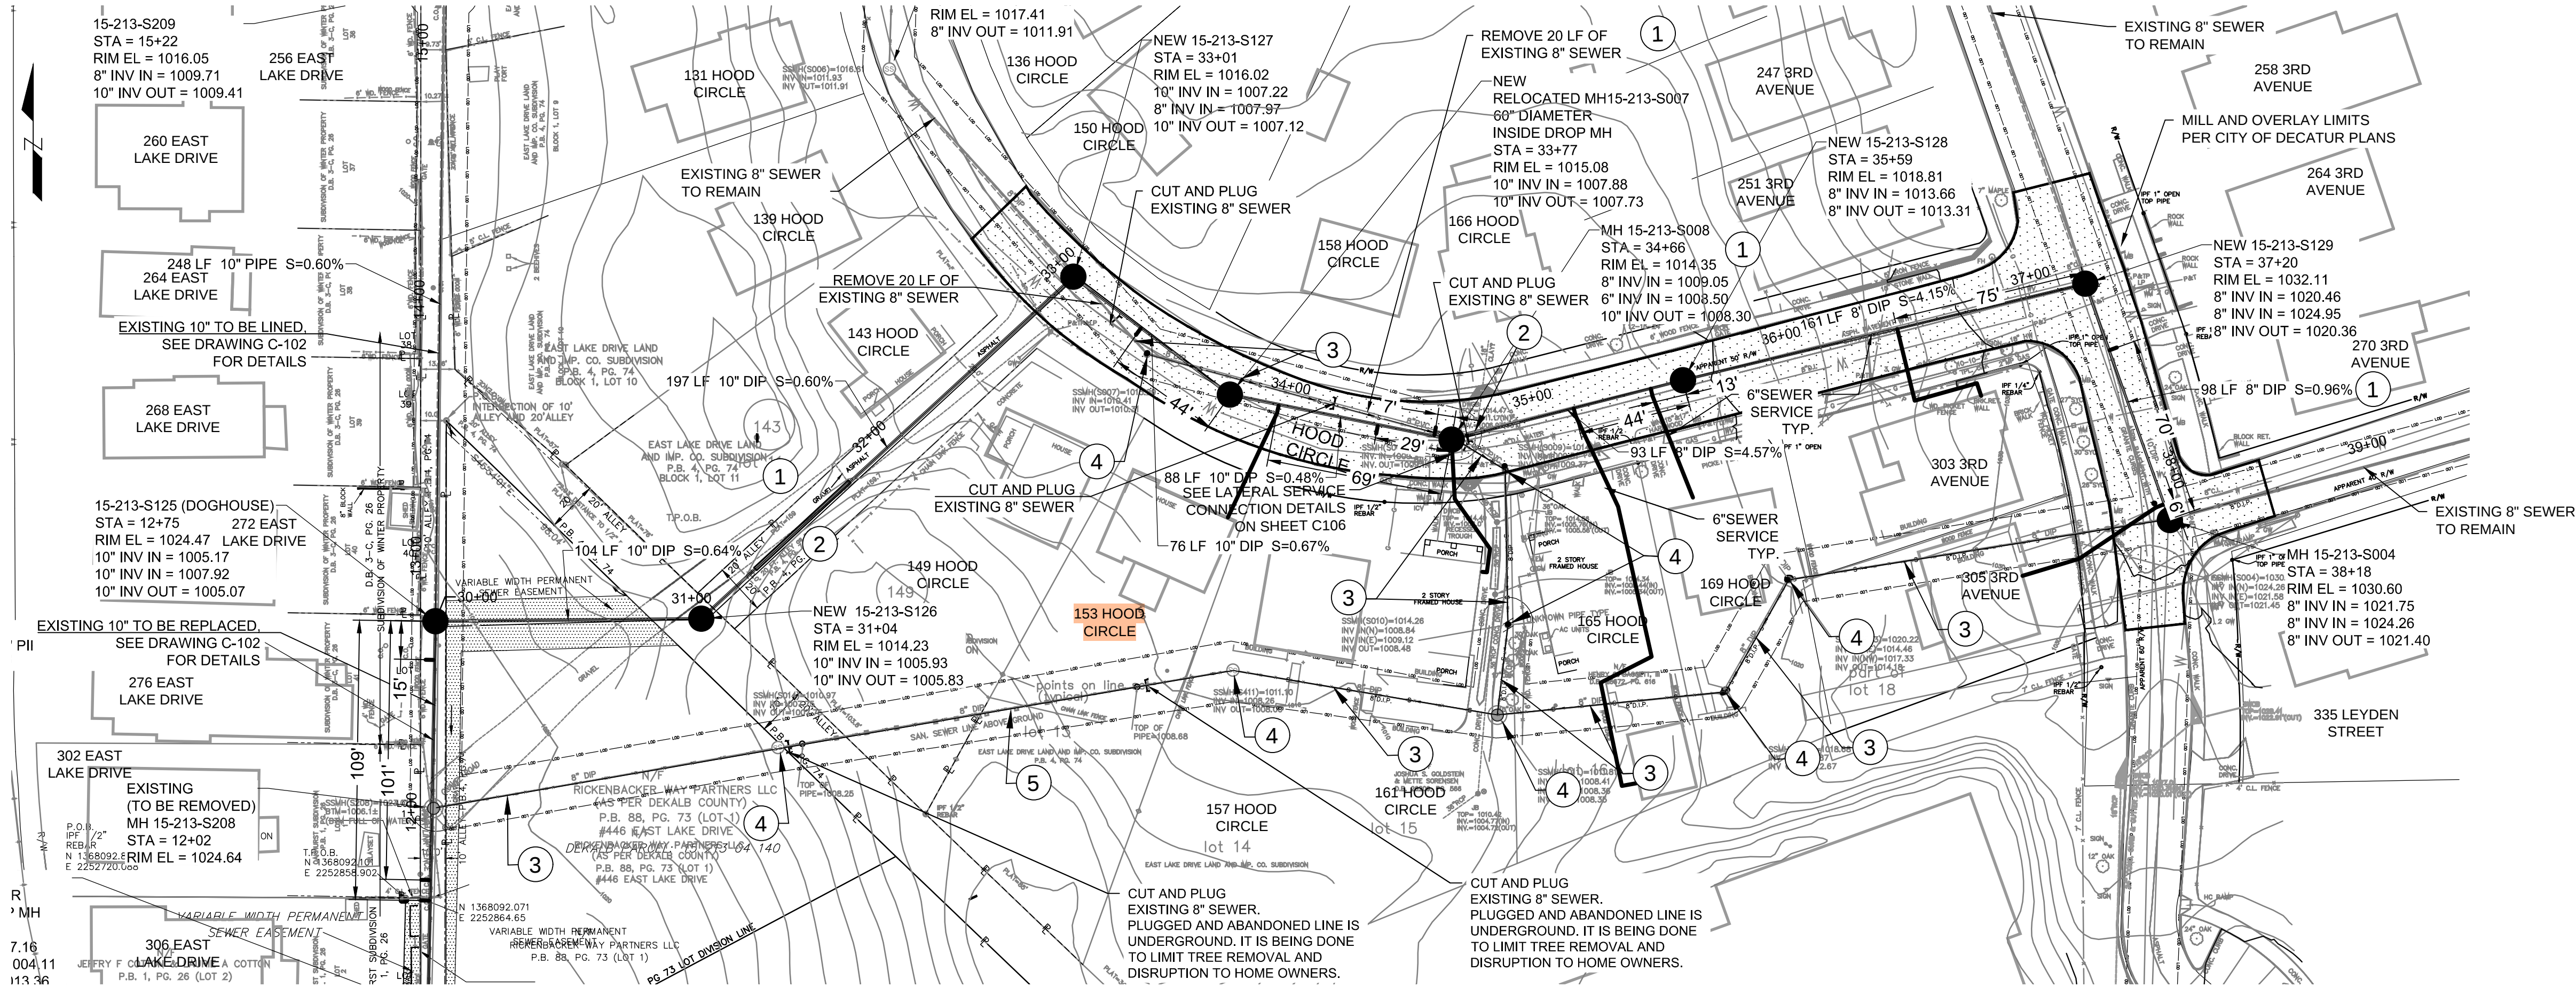

PLAN

SCALE: 1"=40'

MANHOLE REHABILITATION / REPLACEMENT SCHEDULE								
MANHOLE NO.	STATION	DEPTH (APPROX. FEET)	MH DIAM. (INCH)	LOCATION	ACTION	DETAIL	FRAME AND COVER (DETAIL)	
NEW 15-213-s126	31+04	8.3	48	143 HOOD CIRCLE BACKYARD ALLEY	INSTALL NEW PER DEKALB COUNTY STANDARD PRECAST MANHOLE	S-001 / C-001	TRAFFIC (S-009 / C-002)	1368201.11 2252974.23
NEW 15-213-s127	33+01	8.8	60	HOOD CIRCLE	INSTALL NEW PER DEKALB COUNTY STANDARD PRECAST MANHOLE	S-027 / C-003	TRAFFIC (S-009 / C-002)	1368334.45 2253119.45
RELOCATED MH15-213-S007	33+77	7.4	48	HOOD CIRCLE	INSTALL NEW PER DEKALB COUNTY STANDARD PRECAST MANHOLE	S-001 / C-001	TRAFFIC (S-009 / C-002)	1368288.49 2253180.48
MH 15-213-S008	34+66	6.1	48	HOOD CIRCLE	REPLACE PER DEKALB COUNTY STANDARD PRECAST MANHOLE	S-001 / C-001	TRAFFIC (S-009 / C-002)	1368270.94 2253267.01
NEW 15-213-s128	35+59	5.5	48	HOOD CIRCLE	INSTALL NEW PER DEKALB COUNTY STANDARD PRECAST MANHOLE	S-001-/C-001	TRAFFIC (S-009 / C-002)	1368294.10 2253357.30
NEW 15-213-s129	37+20	11.7	60	3RD AVENUE & HOOD CIRCLE INTERSECTION	INSTALL NEW PER DEKALB COUNTY STANDARD PRECAST MANHOLE	S-027 / C-003	TRAFFIC (S-009 / C-002)	1368331.74 2253514.30
MH 15-213-S004	38+18	9.2	48	3RD AVENUE & LEYDEN ST INTERSECTION	REPLACE WITH DEKALB COUNTY STANDARD PRECAST MANHOLE	S-001-/C-001	TRAFFIC (S-009 / C-002)	1368239.57 2253547.31

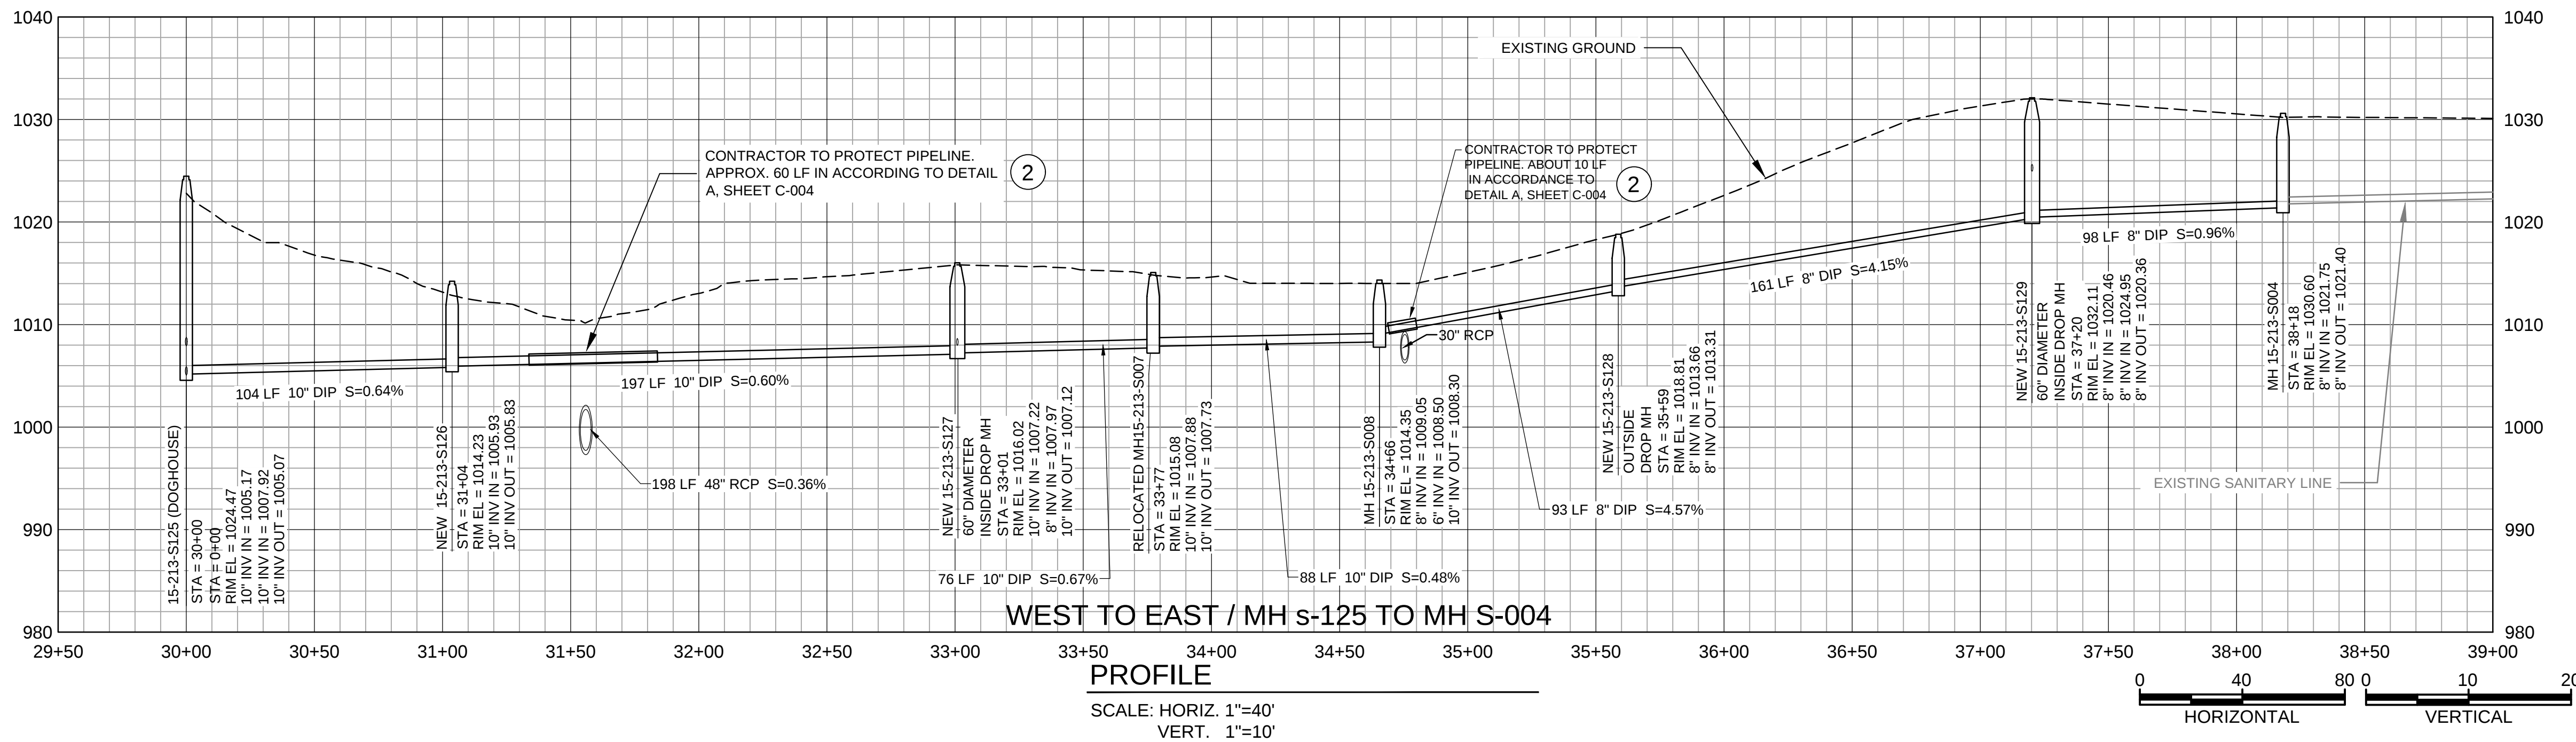

- 1 CONSTRUCT 8-INCH AND 10-INCH SEWER PIPE PER SPECIFICATION SECTION 02622 AND 02537.
- 2 CONCRETE ENCASUREMENT TO BE PROVIDED PER DETAIL A, SHEET C-004.
- 3 EXISTING PIPE TO BE FILLED WITH FLOWABLE FILL AND ABANDONED.
- 4 EXISTING MANHOLE TO BE ABANDONED PER DETAIL S-004, SHEET G-03.
- 5 EXISTING 140 LF SECTION OF EXISTING AERIAL SANITARY LINE TO BE REMOVED. EXISTING PIPE SUPPORTS/PIERS TO BE REMOVED AS WELL.

LEGEND:



SURVEYED RECORD DRAWINGS STATEMENT:

THIS RECORD DRAWING WAS PREPARED USING INFORMATION REPORTED TO BROWN AND CALDWELL FROM FIELD MARK UPS BY RUBY COLLINS, AND ACR ASBLUIT SURVEY. THE ENGINEER SEAL INDICATES THE INFORMATION WAS VERIFIED BY THE ENGINEER. THE ENGINEER HAS NOT INDEPENDENTLY VERIFIED THIS INFORMATION. CONSTRUCTION-RELATED NOTES AND REFERENCES FROM THE IFC DRAWINGS REMAIN ON THESE RECORD DRAWINGS TO MAINTAIN THE DOCUMENTATION OF THE WORK PERFORMED.



CERT. NO. 0000070007



REVISIONS		DESCRIPTION
No.	DATE	
A.	JUNE 2020	SURVEYED RECORD DRAWINGS



DRAWING NUMBER: **C-104**
DEKALB COUNTY
CONTRACT NO. 1060049
PACKAGE 1
SHEET DISCIPLINE: **CIVIL**
PR 19-HOOD CIRCLE
SHEET NAME: **HOOD CIRCLE PLAN & PROFILE 4**




Know what's **below**.
Call before you dig.

DESIGNED BY: J BOLANO
DRAWN BY: P DAVIS
CHECKED BY: J BOLANO
DATE: ----
FILE NAME: 151033-P19-C1010106.dwg

SHEET 11 OF 12

153 Hood Circle

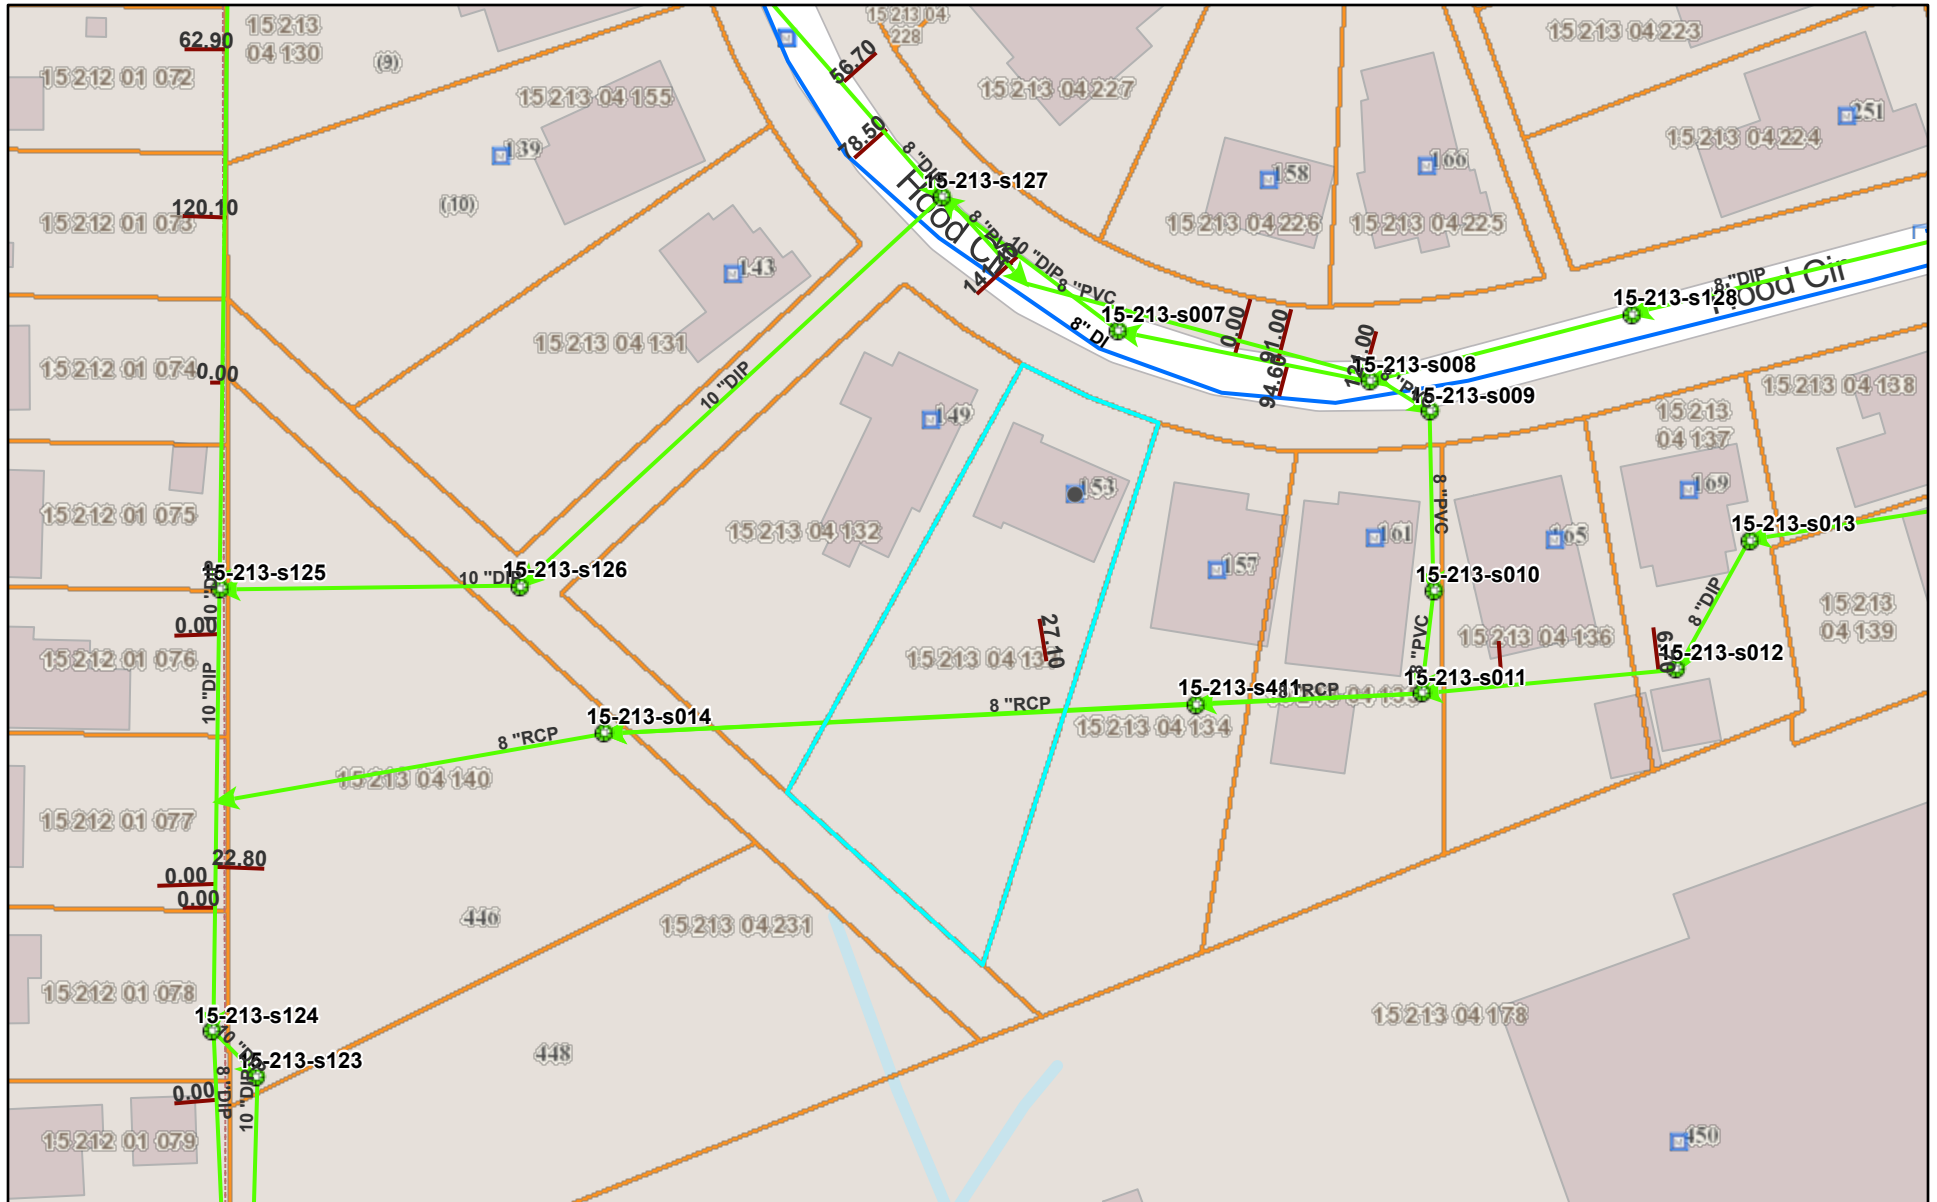

7/30/2024, 11:21:25 AM

Manholes

DEKALB

Sewer Mains

DEKALB

Water Fittings

Plug

Laterals

Water Mains

Water Meter


Land Lot

Districts

Legal Anno

Address

Tax Parcels

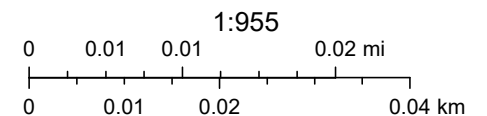

DeKalb County Watershed Management

The data provided in this map is provided for informational and planning purposes only. DeKalb County DWM is not responsible for the misuse or misrepresentation of the data.